


01 Third Floor Plan  
1202 Scale:1:50

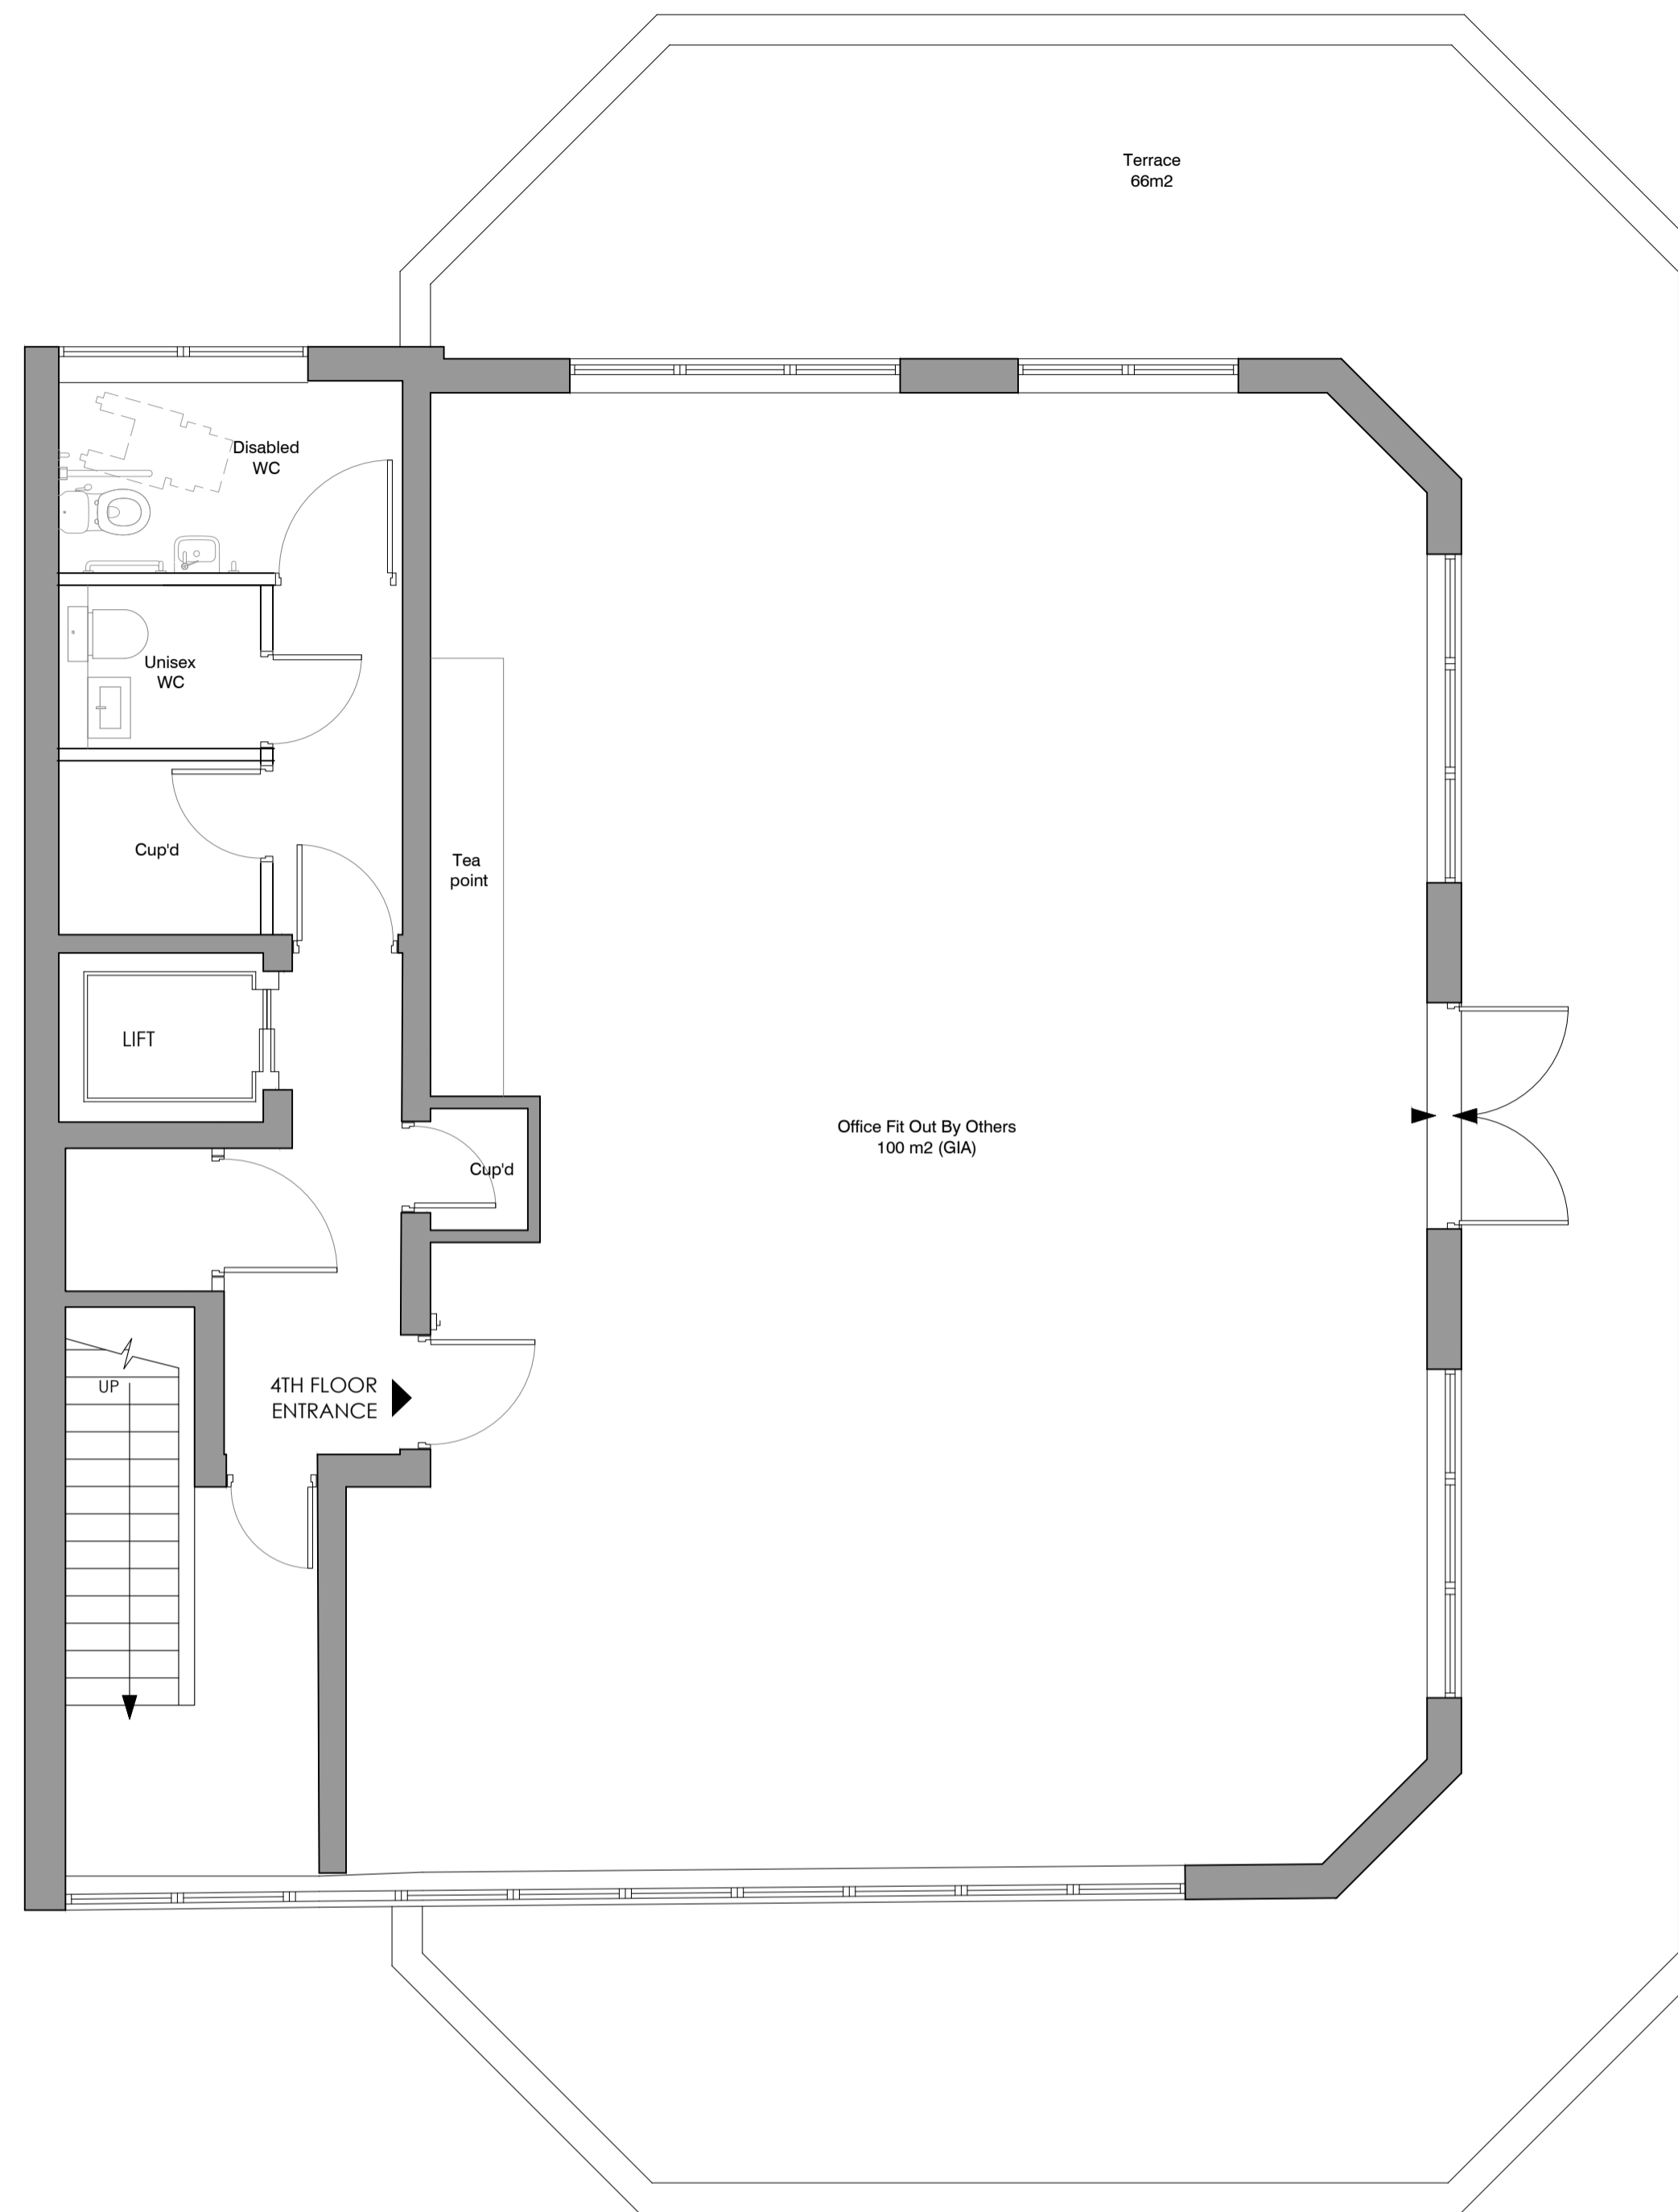

01 Fourth Floor Plan  
1202 Scale:1:50

This drawing is copyright © of Yelo Architects Limited  
Do not scale from this drawing. Work to figured dimensions only.  
Dimensions to be taken on site prior to manufacture, fabrication or installation.  
Any discrepancies to be reported to Yelo Architects immediately.


**ISSUED FOR  
MARKETING**

Rev	Date	Description
M1	09.02.22	As built issue


**YELO** Yelo Architects Ltd  
Mocatta House, Spaces  
Trafalgar Pl,  
Brighton  
BN1 4DU  
T 01273 608 444  
E hello@yeloarchitects.com  
W yeloarchitects.com  
Twitter yeloarchitects

PROJECT YO398  
Claremont House

DRAWING TITLE Proposed Third & Fourth  
Floor Plan  
DRAWING NO YO398 - 1202  
SCALE 1/50 @ A1  
DATE 09/02/22  
REV M1

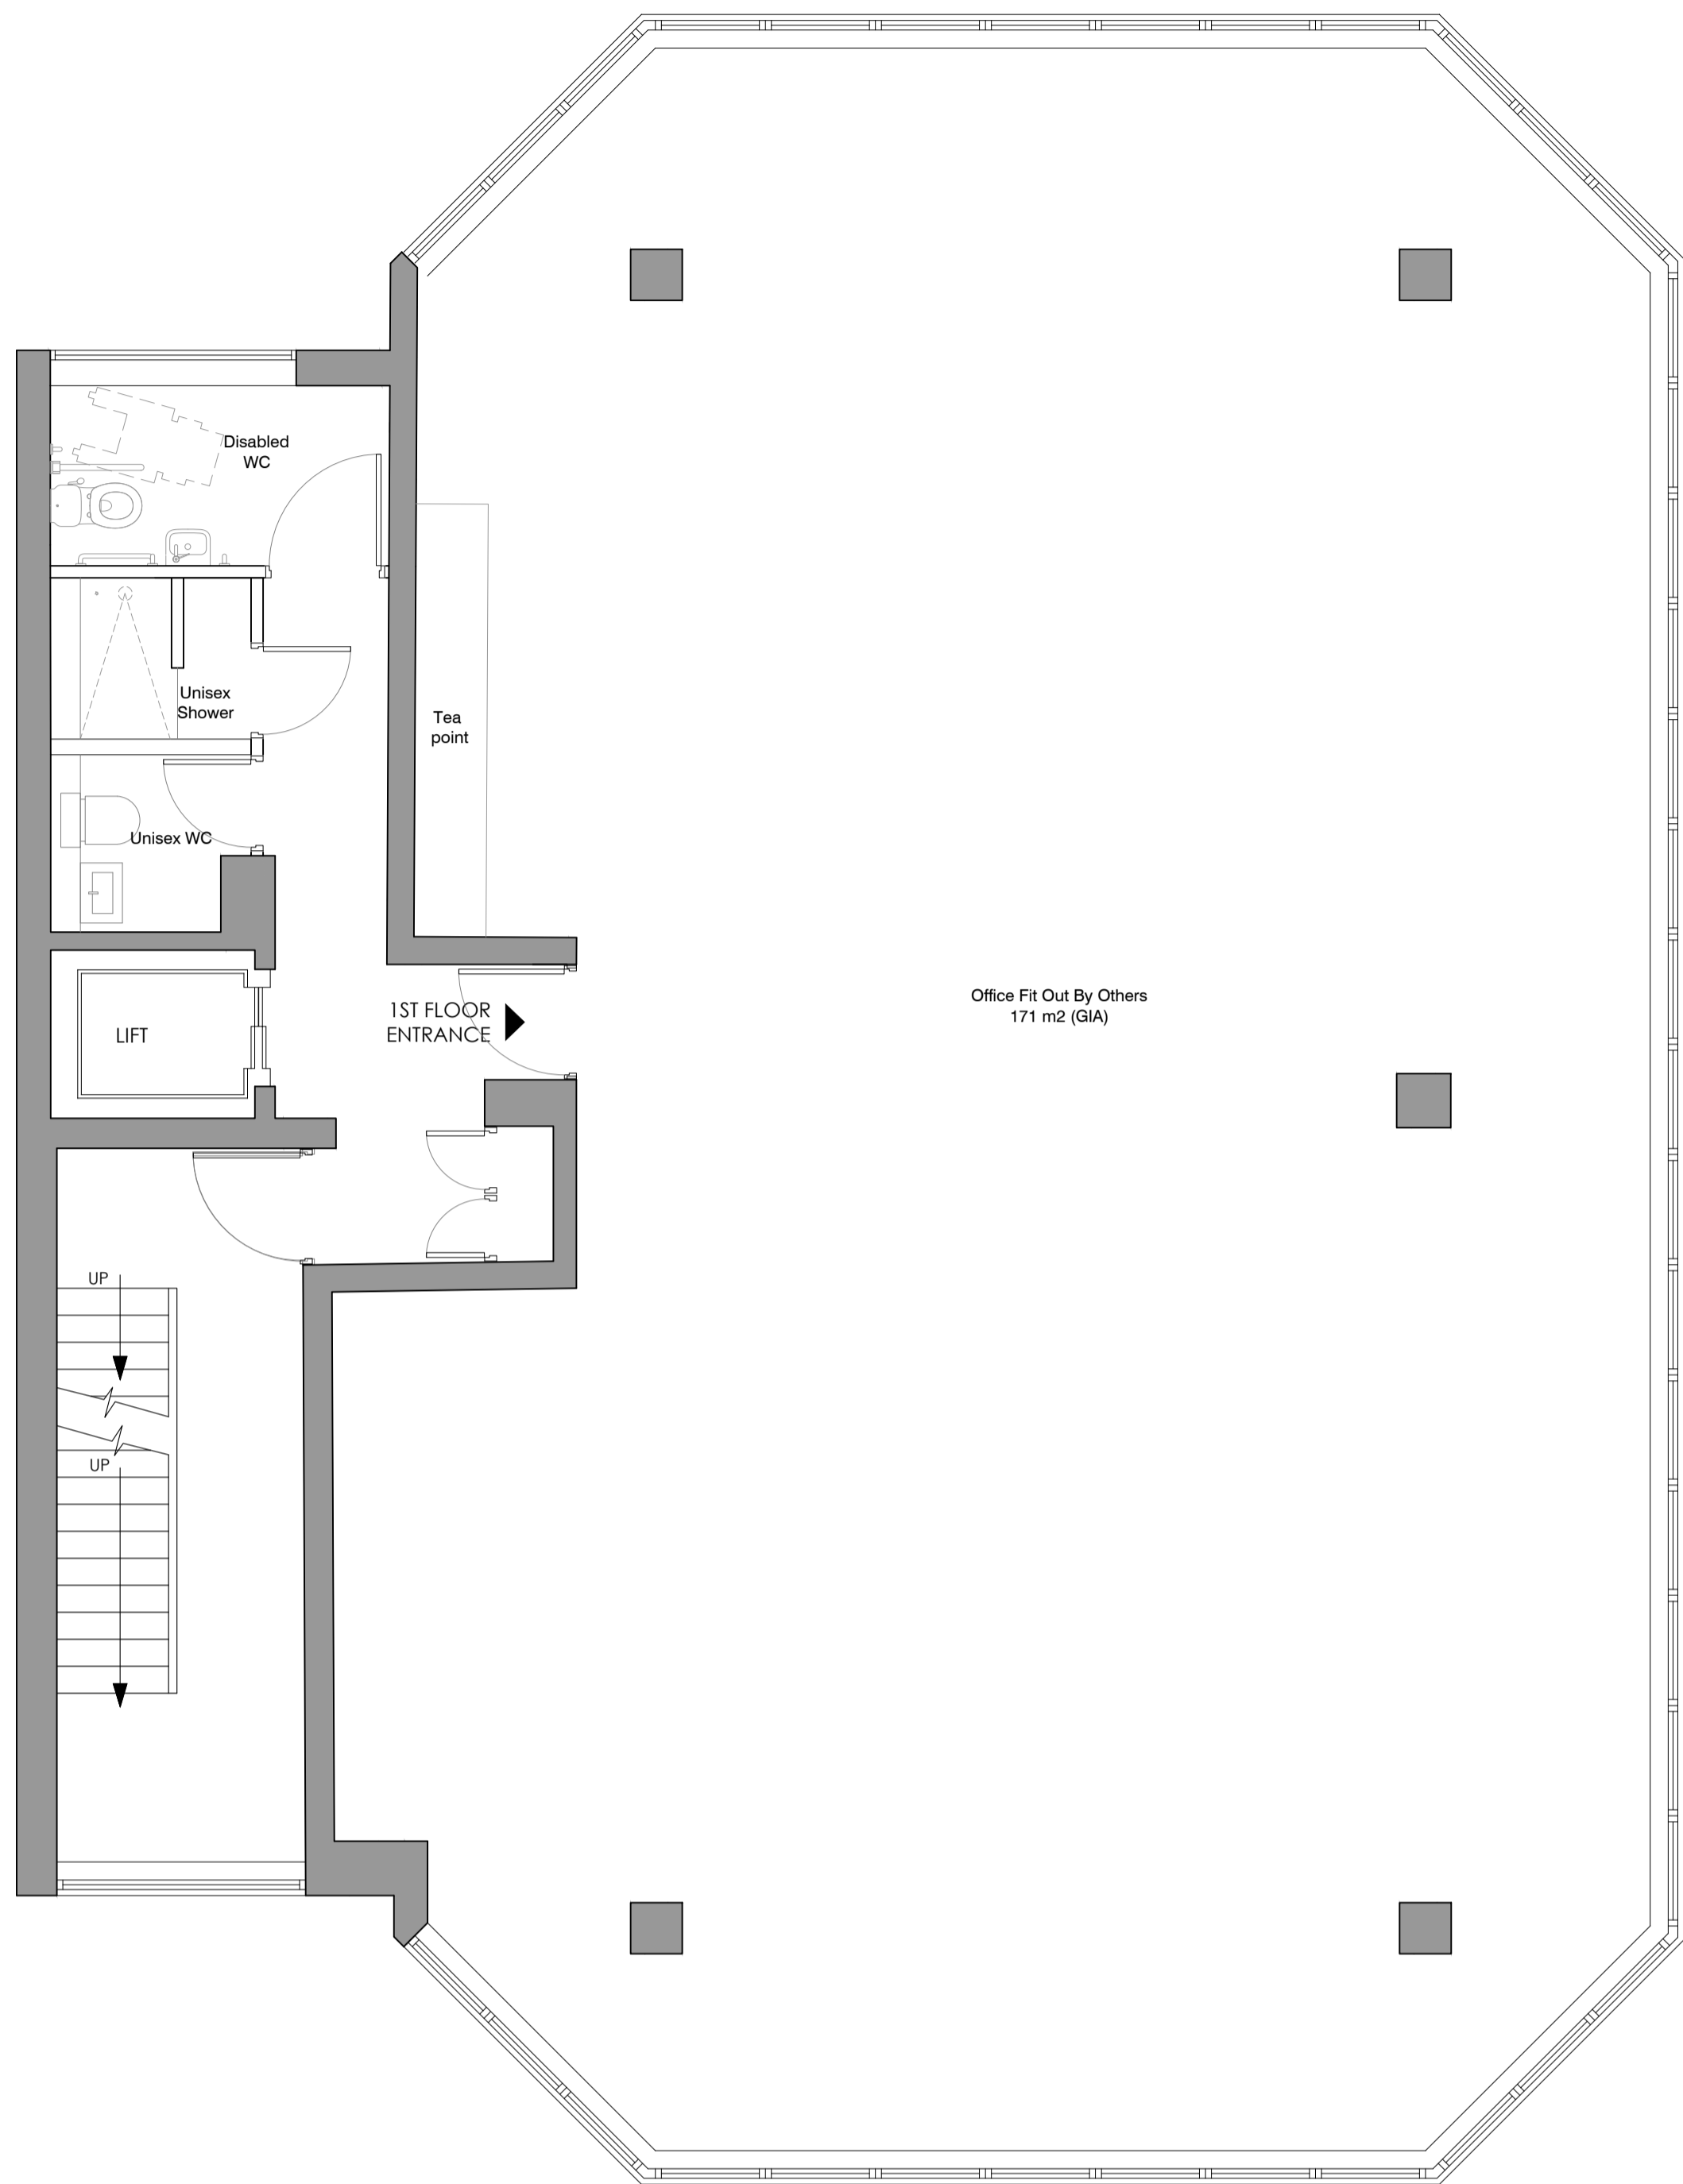

01 First Floor Plan  
1201 Scale:1:50

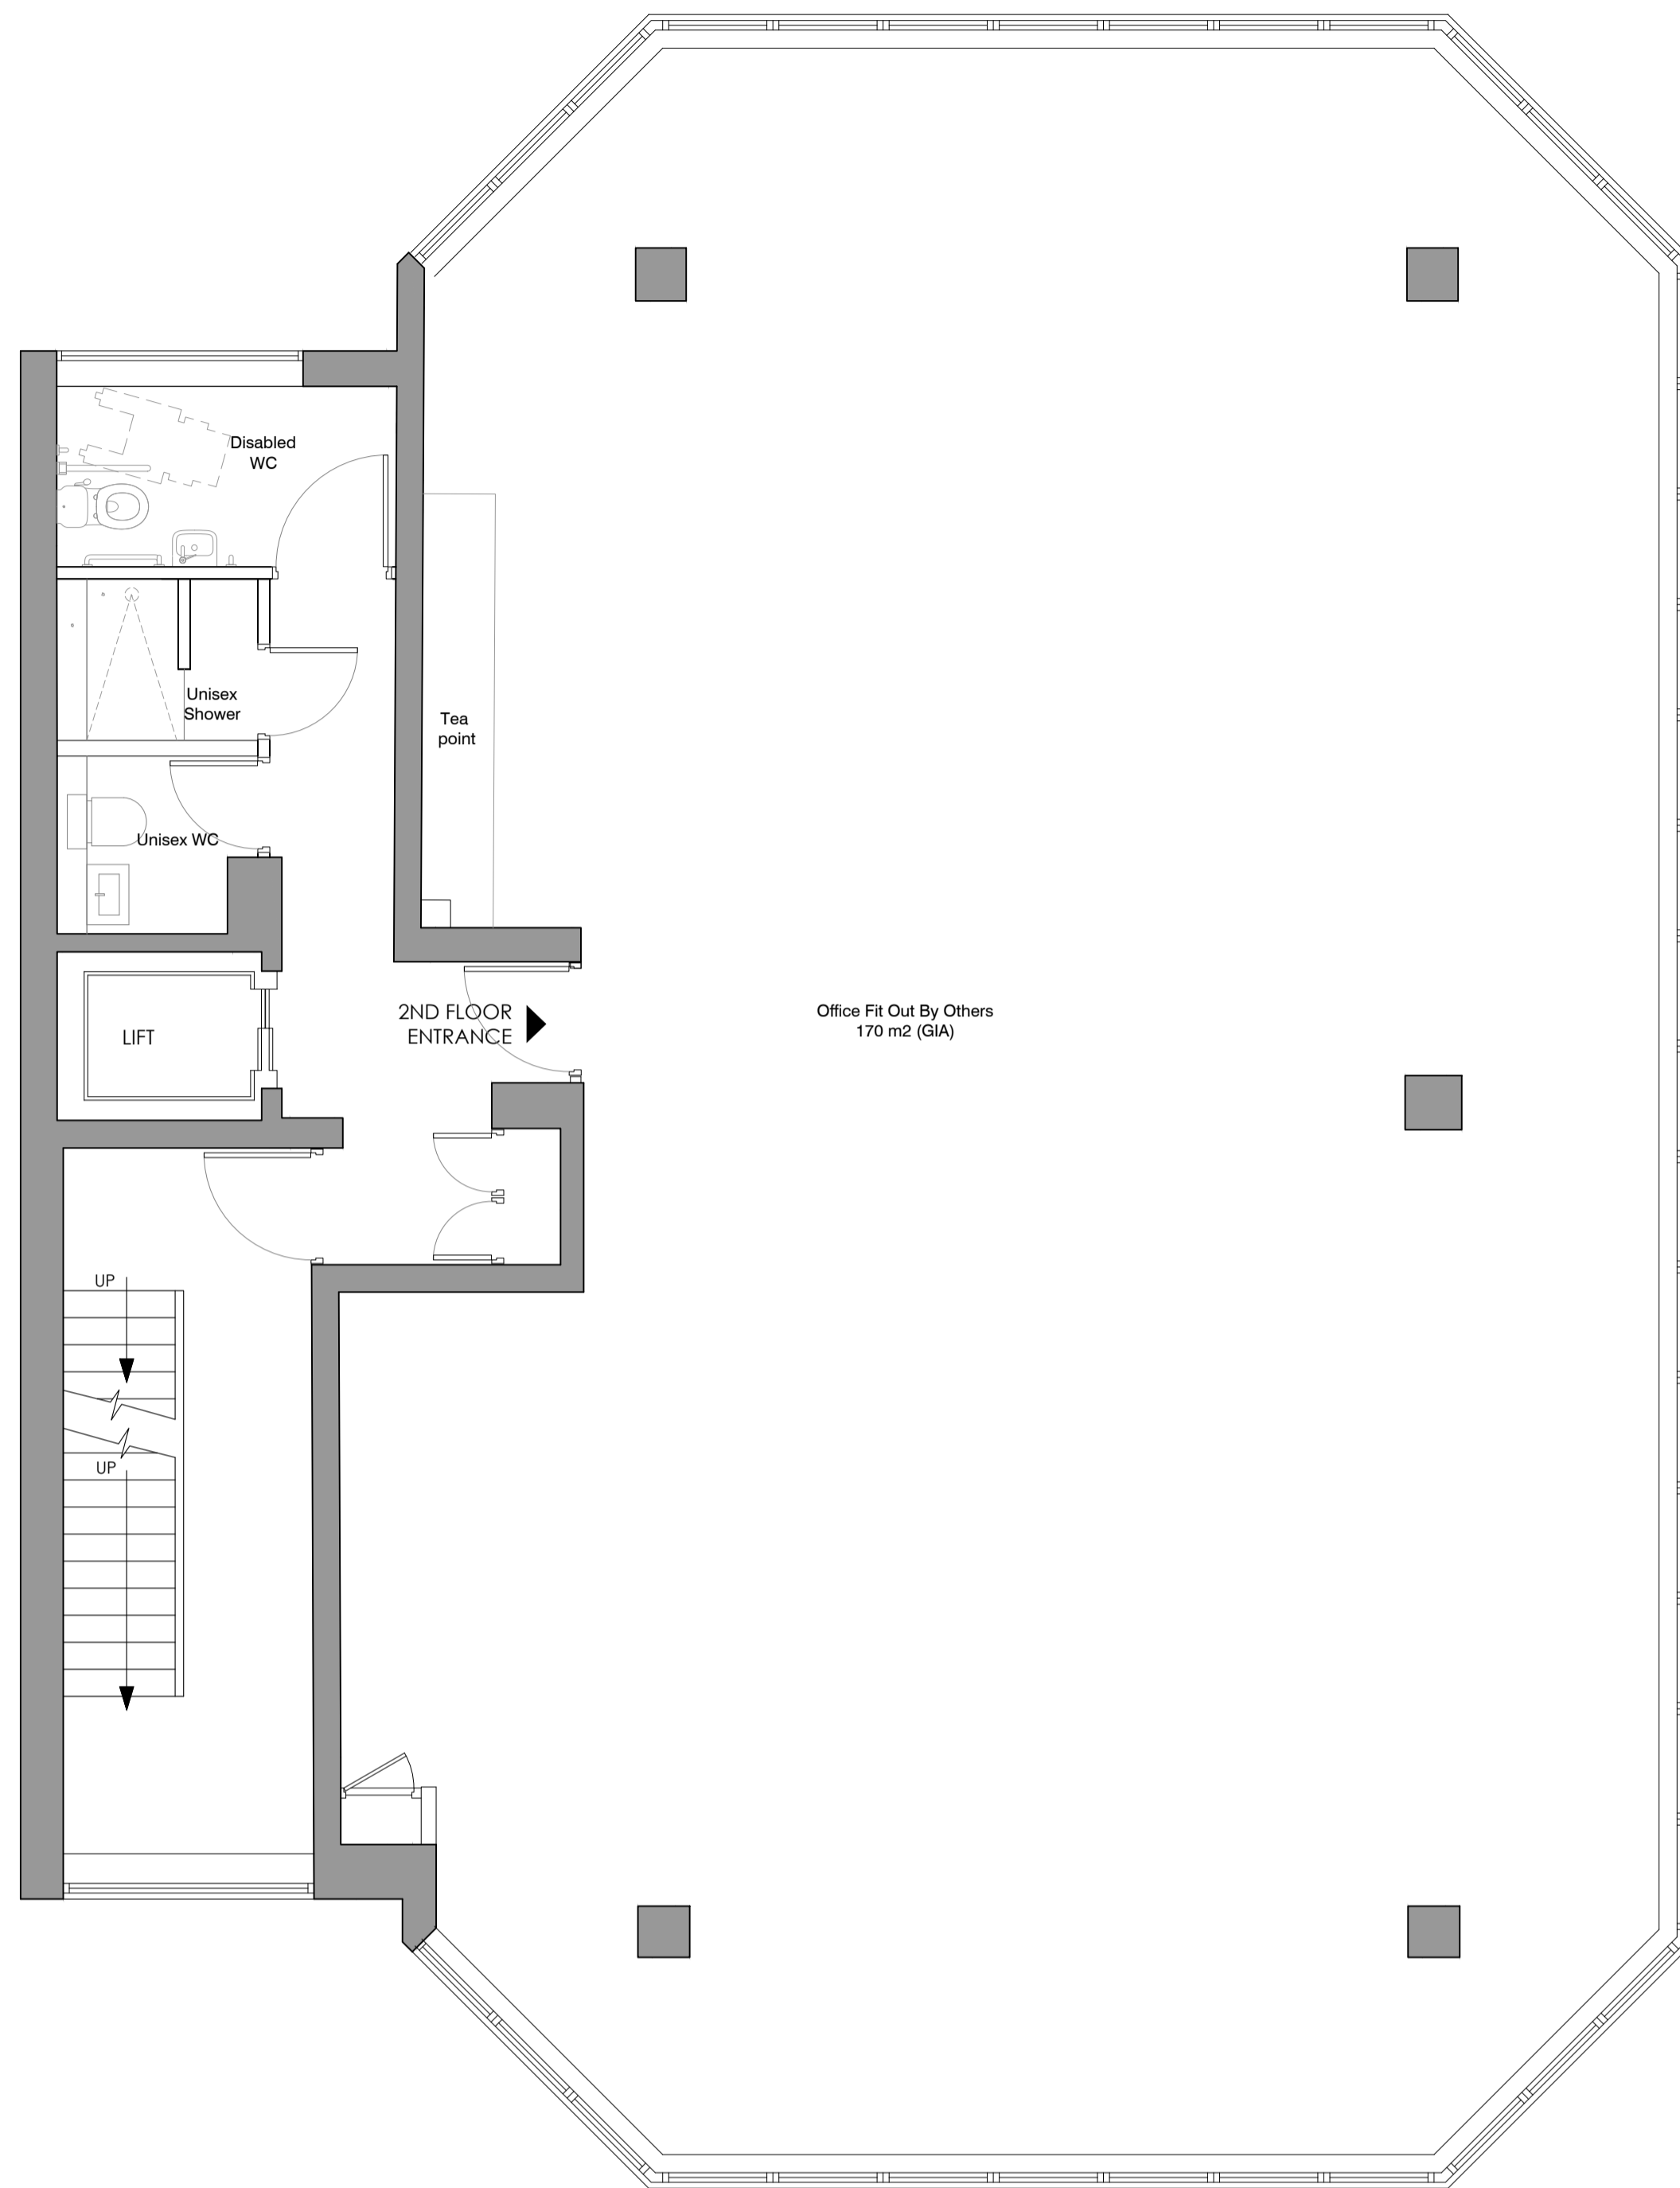

01 Second Floor Plan  
1201 Scale:1:50

This drawing is copyright © of Yelo Architects Limited  
Do not scale from this drawing. Work to figured dimensions only.  
Dimensions to be taken on site prior to manufacture, fabrication or installation.  
Any discrepancies to be reported to Yelo Architects immediately.


**ISSUED FOR  
MARKETING**

Rev	Date	Description
M1	09.02.22	General plan


**YELO** Yelo Architects Ltd  
Mocatta House, Spaces  
Trafalgar Pl,  
Brighton  
BN1 4DU  
T 01273 608 444  
E hello@yeloarchitects.com  
W yeloarchitects.com  
Twitter yeloarchitects

PROJECT YO398  
Claremont House

DRAWING TITLE Proposed First & Second  
Floor Plan  
DRAWING NO YO398 - 1201  
SCALE 1/50 @ A1  
DATE 09/02/22  
REV M1

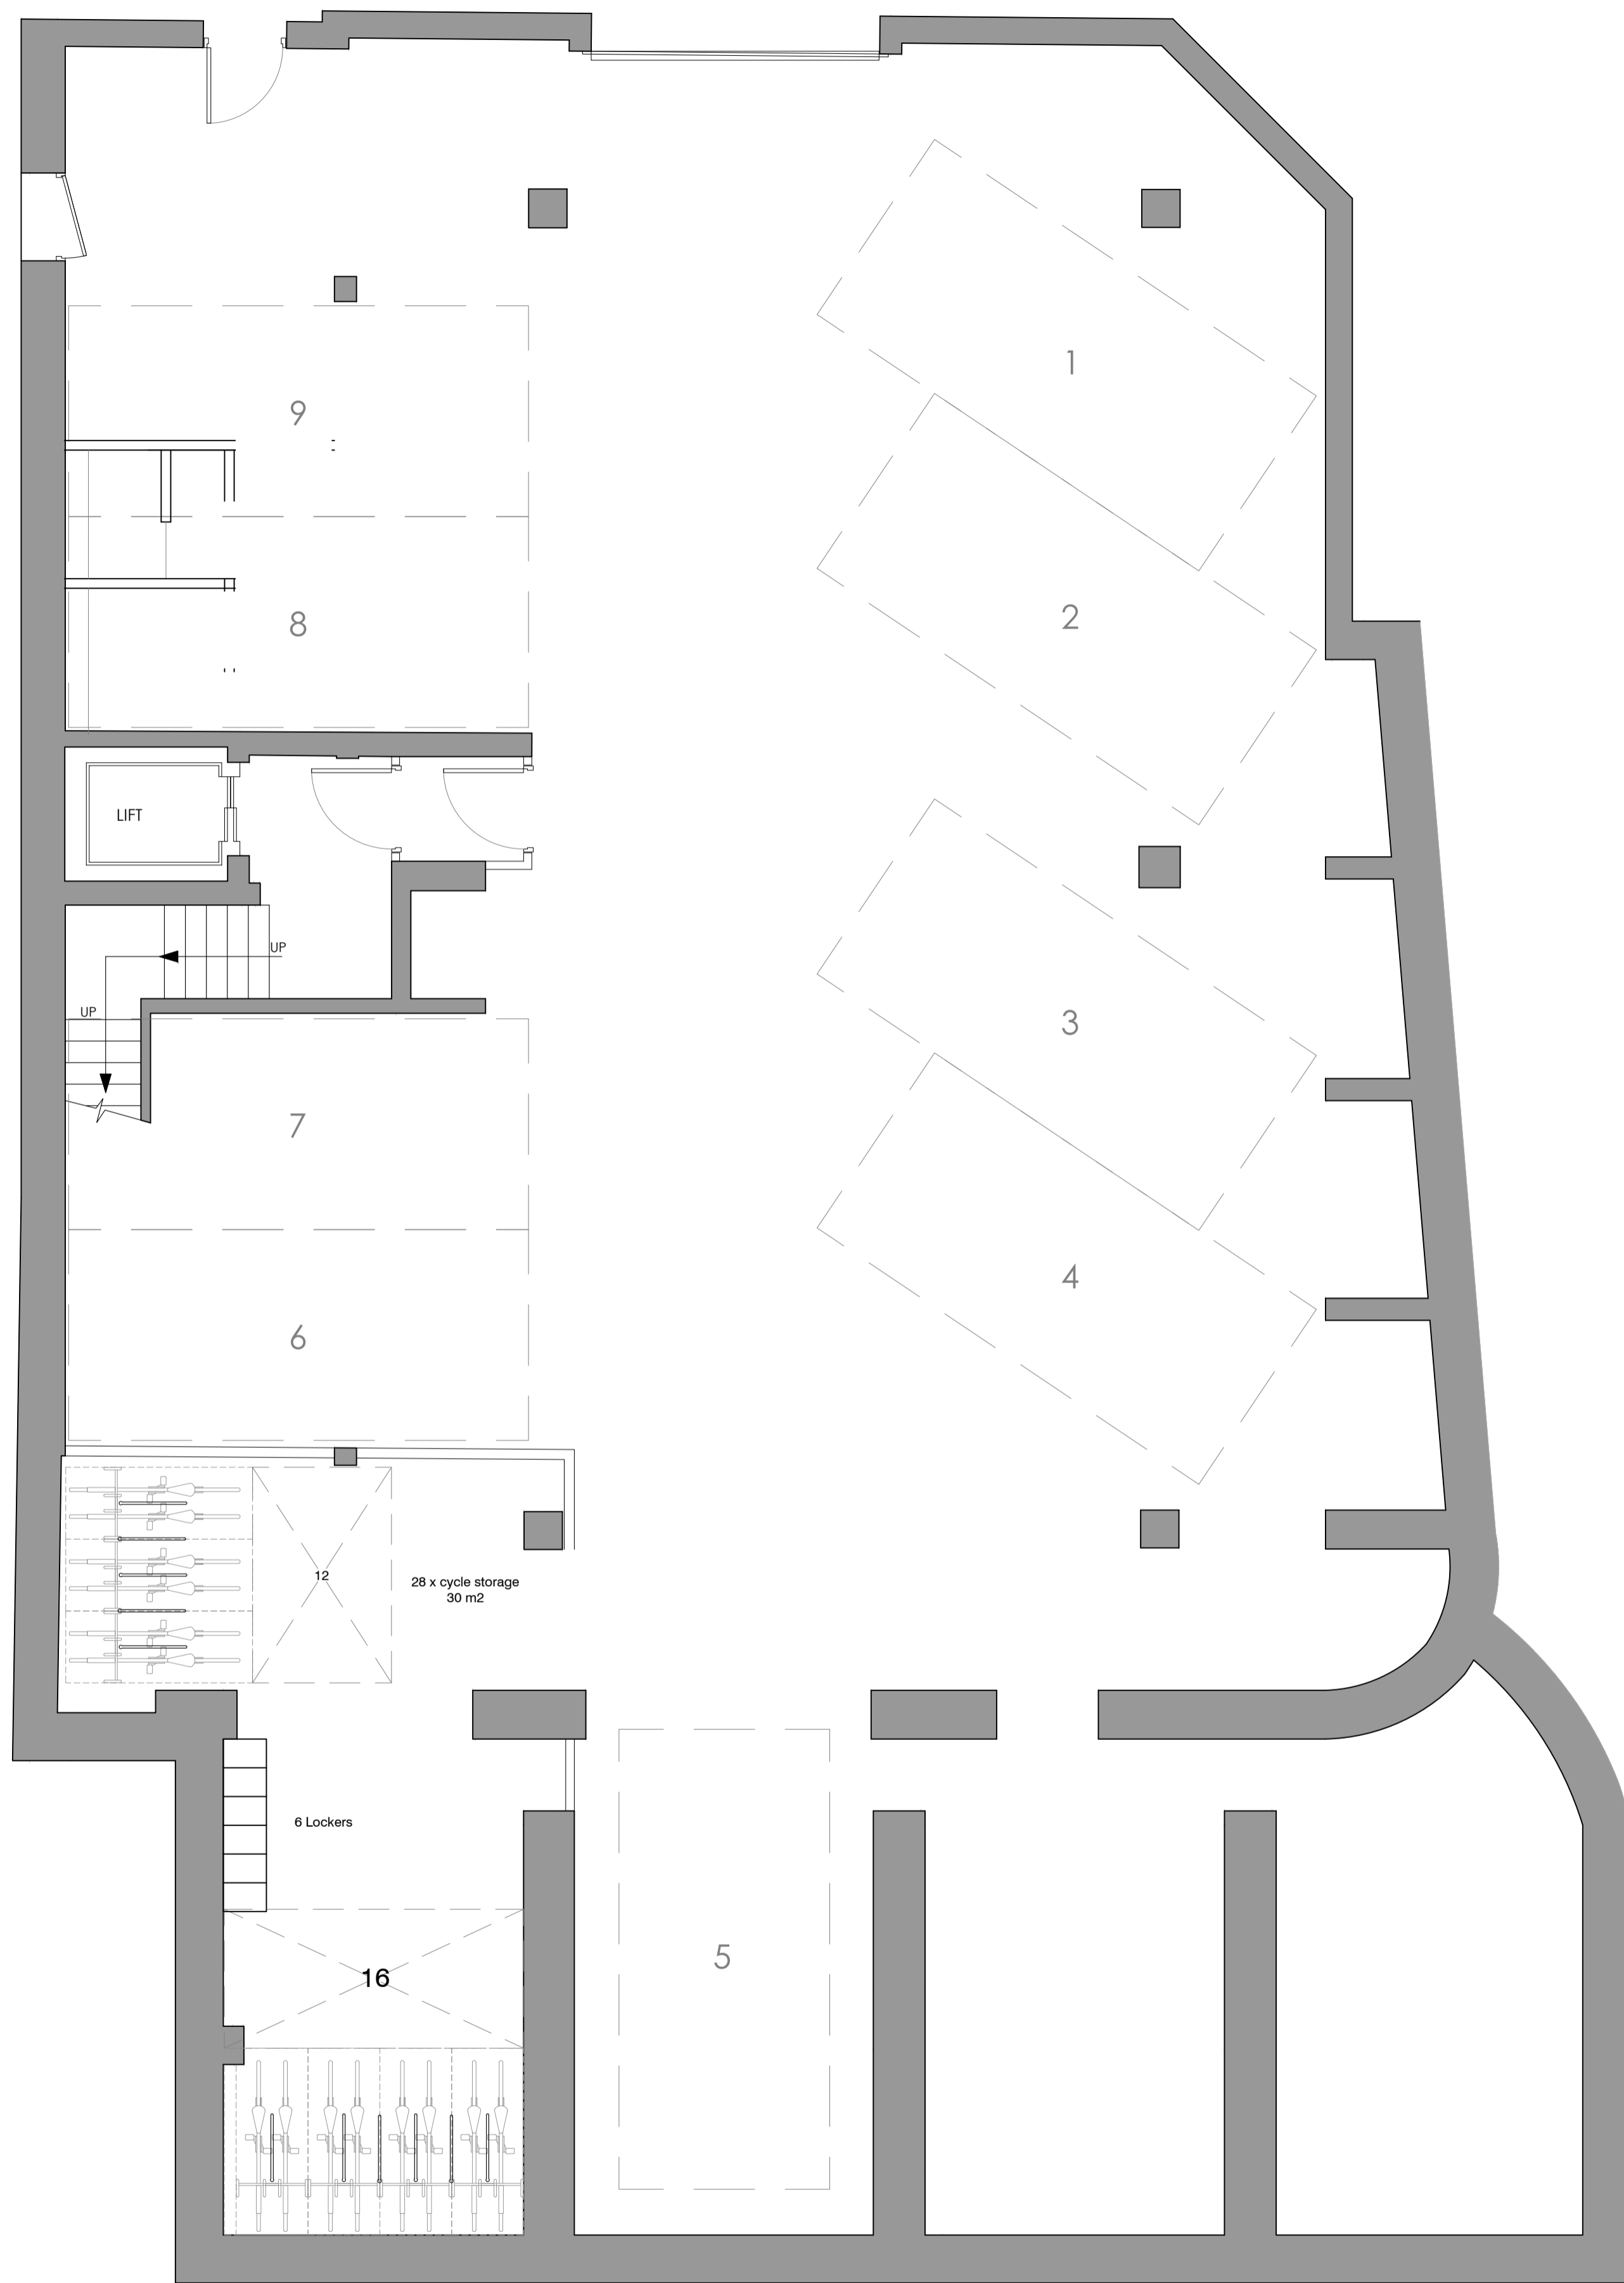

01 Basement Floor Plan  
Scale: 1:50

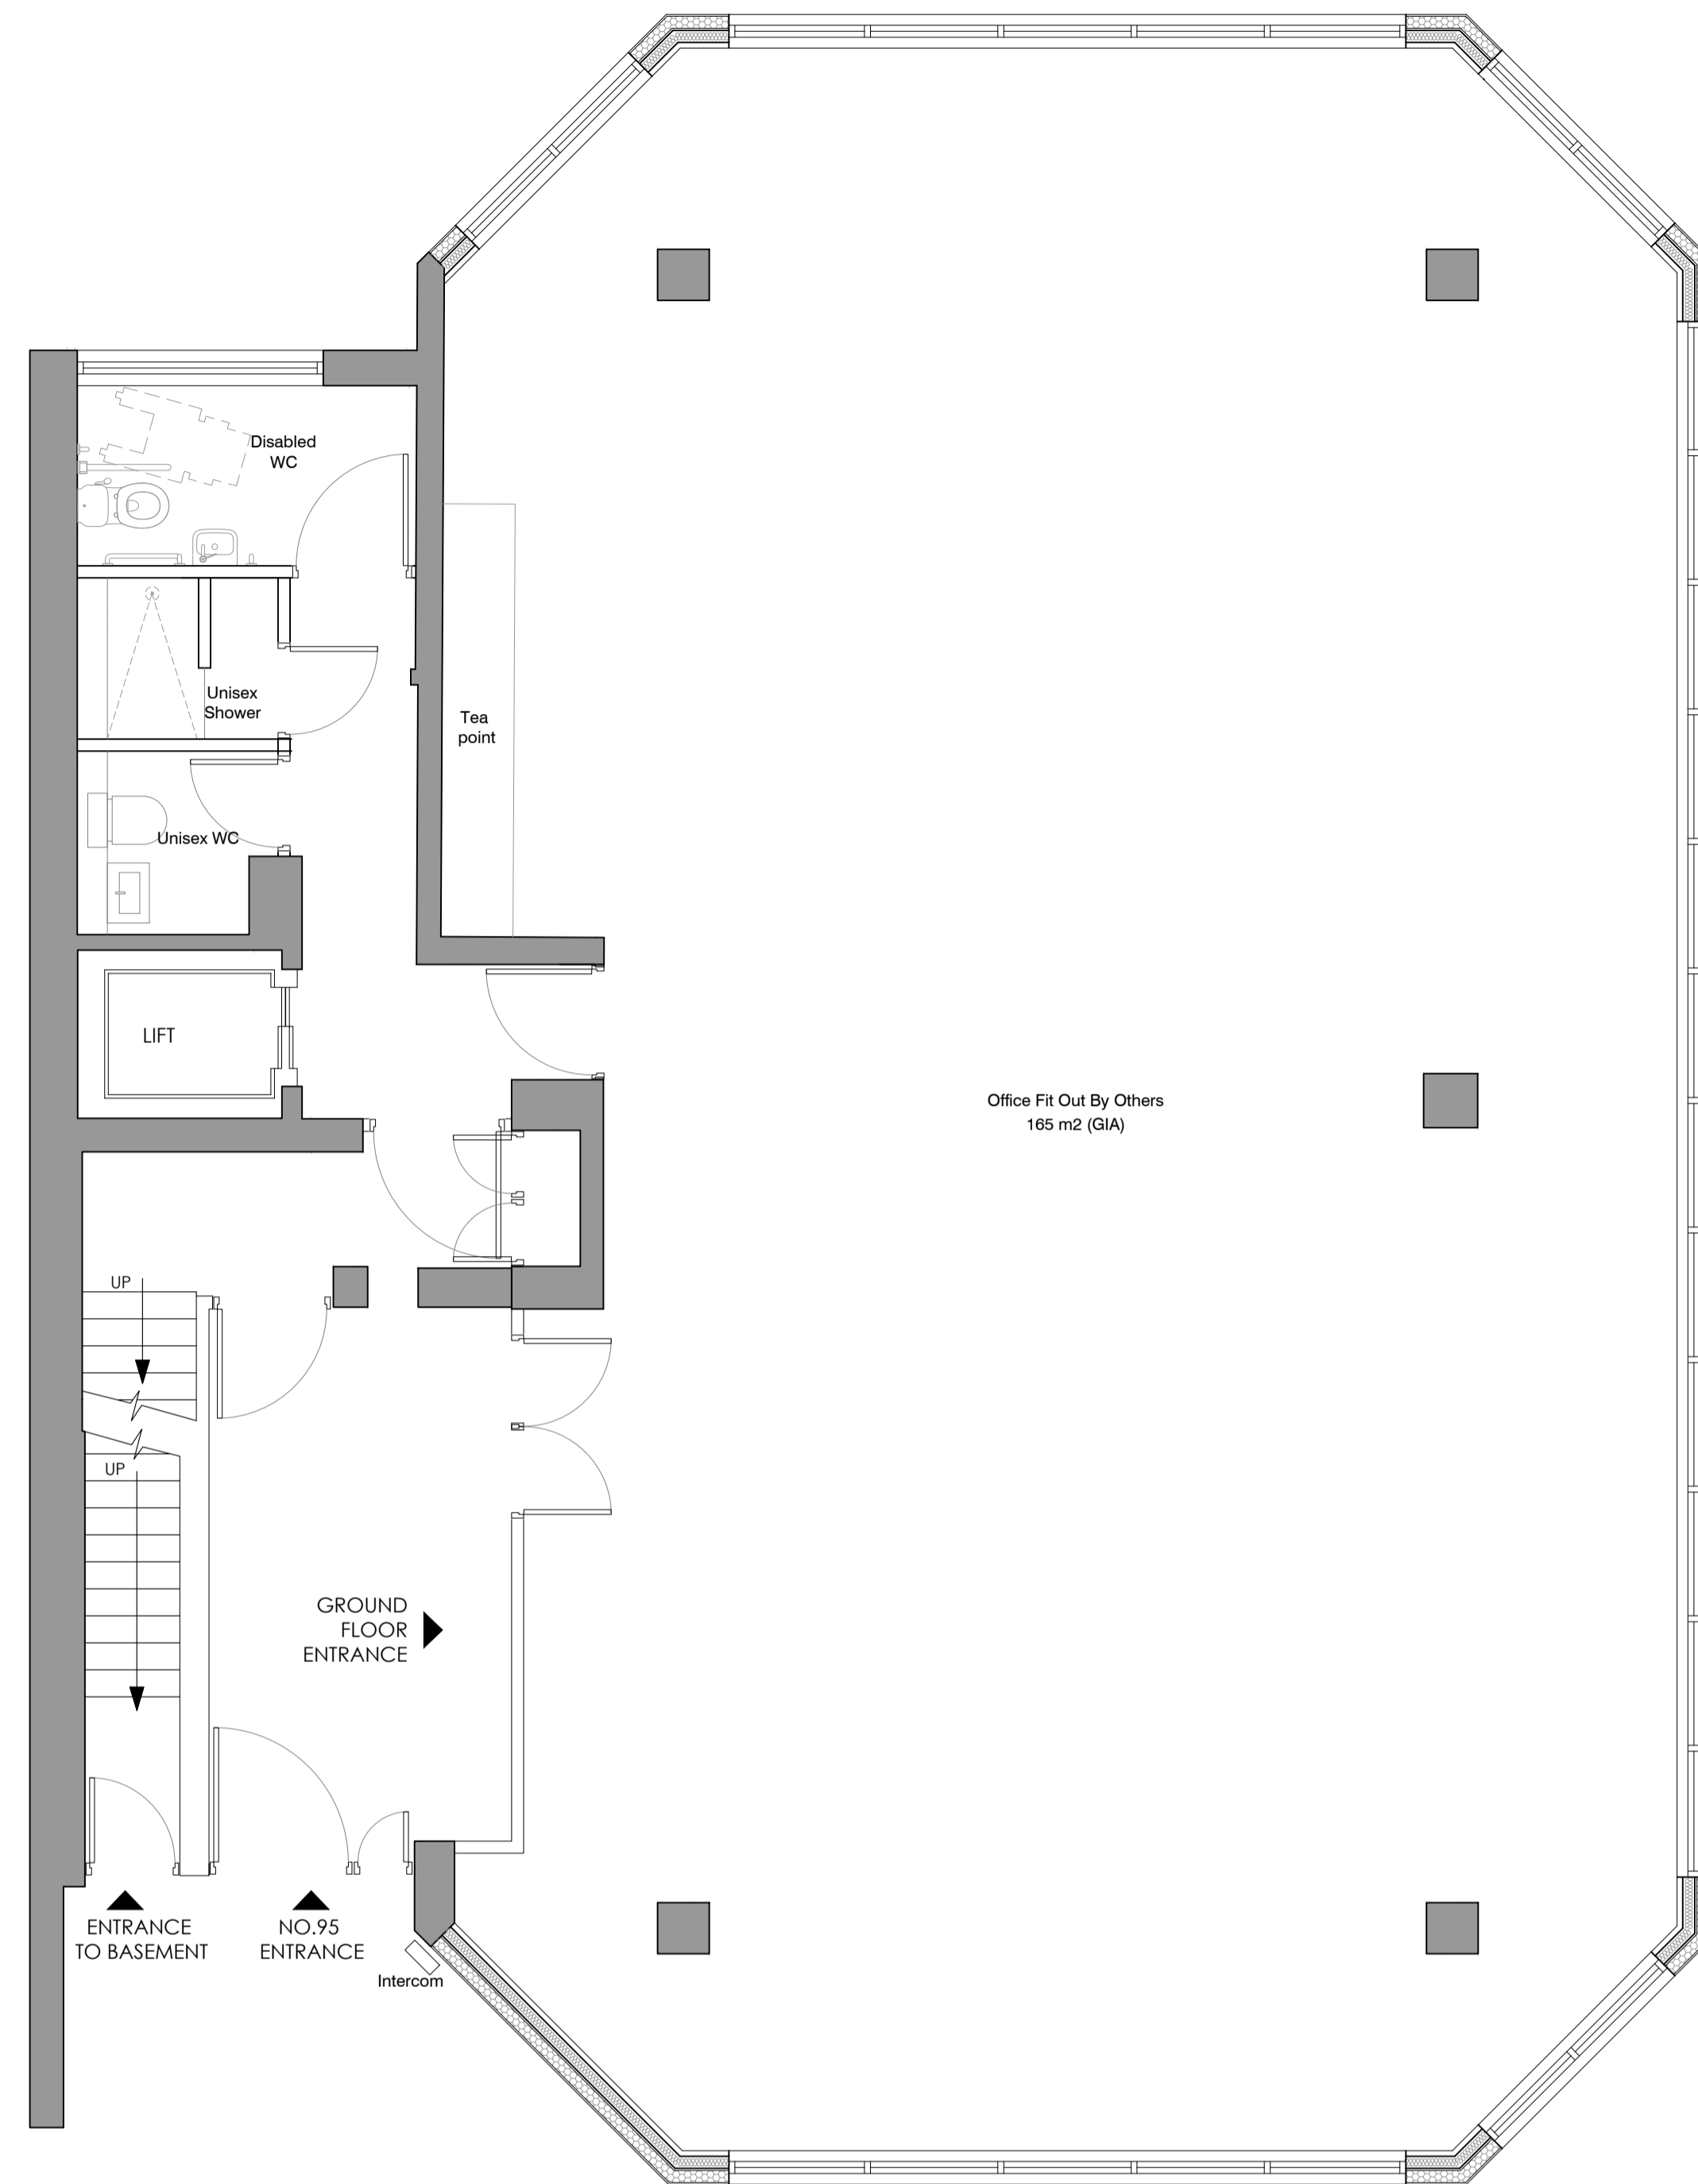

01 Ground Floor Plan  
Scale: 1:50

This drawing is copyright © of Yelo Architects Limited  
Do not scale from this drawing. Work to figured dimensions only.  
Dimensions to be taken on site prior to manufacture, fabrication or installation.  
Any discrepancies to be reported to Yelo Architects immediately.

**ISSUED FOR MARKETING**

Rev	Date	Description
M1	09.02.22	General basement plan

**Yelo** Architects Ltd  
Mocatta House, Spaces  
Trafalgar Pl,  
Brighton  
BN1 4DU

T 01273 608 444  
E hello@yeloarchitects.com  
W yeloarchitects.com  
Twitter yeloarchitects

PROJECT YO398  
Claremont House

DRAWING TITLE Proposed Basement &  
Ground Floor Plan  
DRAWING NO YO398 - 1200  
SCALE 1/50 @ A1  
DATE 09/02/22  
REV M1