

CLIENT	UNIT A, WOOLBOROUGH LANE, CRAWLEY	STAGE 4/5	STAGE 4 - ISSUED AS BUILT	
DRWG	PROPOSED GROUND FLOOR AS BUILT			
JOB / DRWG NO	1293-SK203F JAN 2020	REVISION NOTE	LAYOUTS UPDATED TO AS BUILT CONDITION	
DRWG SCALES	1/ 200 @ A2	ISSUE DATE	15-02-22	EMAIL & POST




General Queries & Contact Us			
* OFFICE	34 Dover Street, London W1S 4NG		
F OFFICE	0203 589 0050	DESIGNER	P TOMLINSON
8 OFFICE	ptomlinson@vailwilliams.com		

NOTES
1- THE DRAWING MAY BE SCALED, BUT PLEASE CROSS CHECK ON SITE
2- THE CONTRACTOR IS TO CHECK ALL WRITTEN DIMENSIONS ON SITE
3- ANY DISCREPANCIES SHOULD BE REPORTED TO VAIL WILLIAMS FOR ADVICE
4- WORKS TO COMPLY WITH BREITENBURG HEAVY & BUILDING REGULATIONS
5- THE COPYRIGHT OF THIS DESIGN REMAINS WITH VAIL WILLIAMS

NOTES

- 1- THIS DRAWING MAY BE SCALED BUT PLEASE CROSS CHECK ON SITE
- 2- THE CONTRACTOR IS TO CHECK ALL WRITTEN DIMENSIONS ON SITE
- 3- ANY DISCREPANCIES SHOULD BE REPORTED TO VAIL WILLIAMS FOR ADVICE
- 4- WORKS TO COMPLY WITH BRITISH STANDARDS & BUILDING REGULATIONS
- 5- THE COPYRIGHT OF THIS DESIGN REMAINS WITH VAIL WILLIAMS

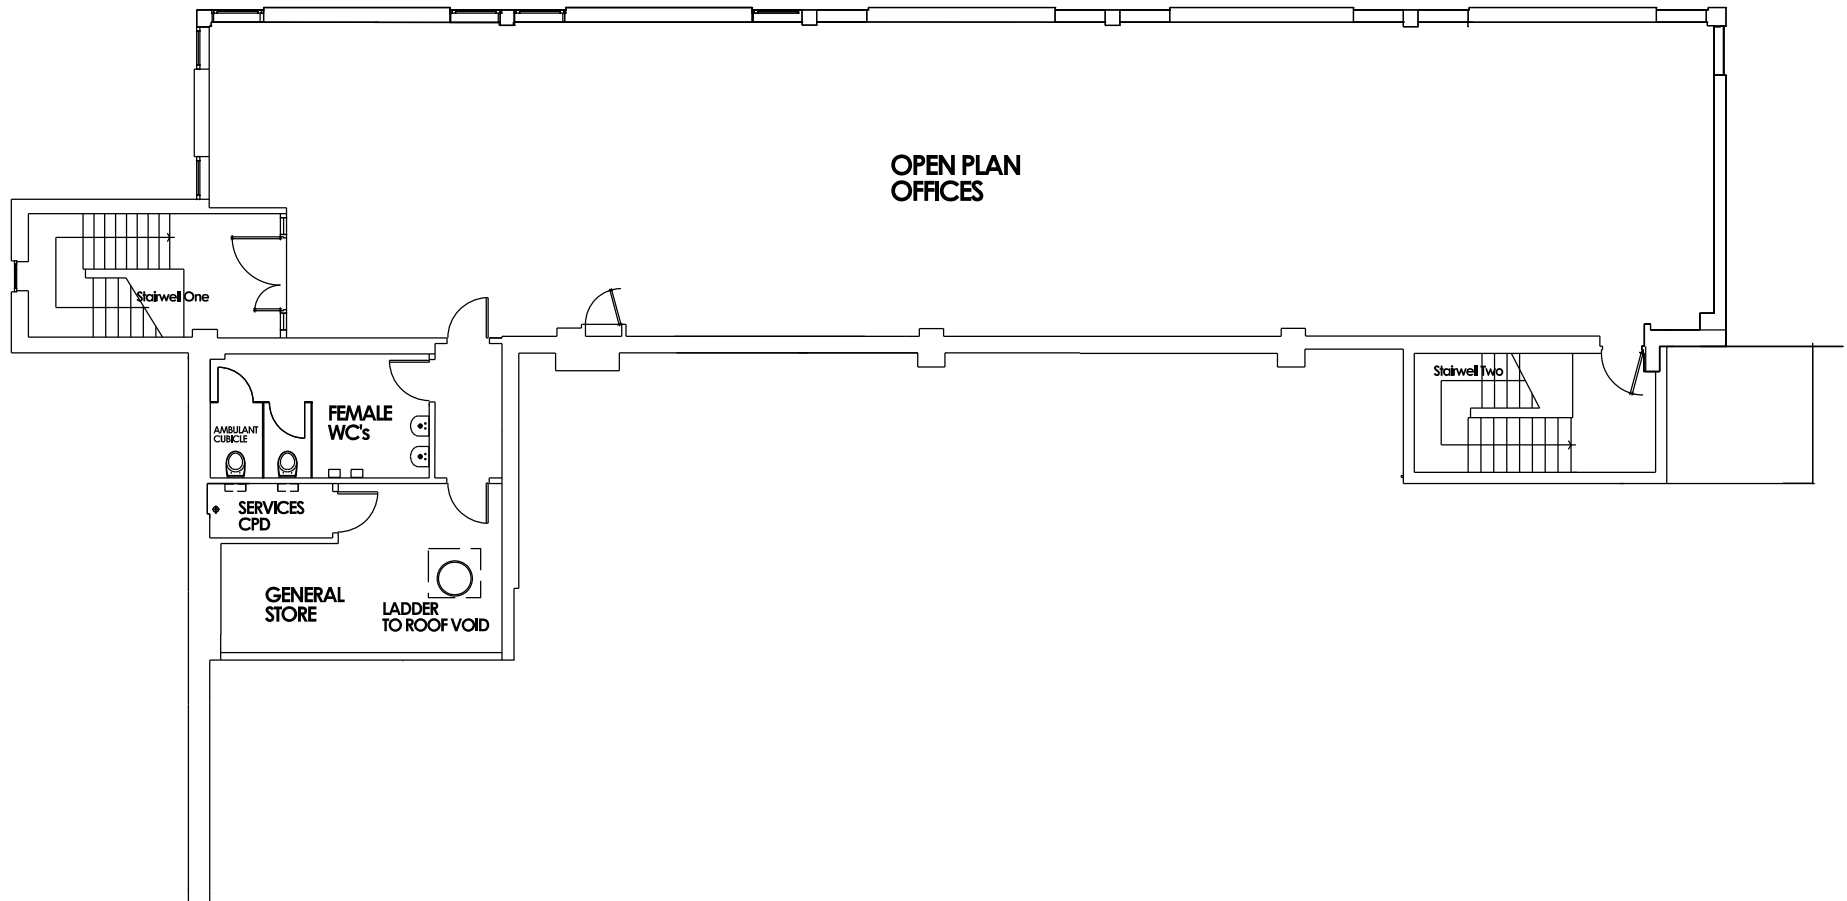

CLIENT	UNIT A, WOOLBOROUGH LANE, CRAWLEY	STAGE 4/5	STAGE 4 - ISSUED AS BUILT FOR RECORDS	General Queries & Contact Us			
DRWG	FIRST FLOOR (AS BUILT)			* OFFICE	34 Dover Street, London W1S 4NG		
JOB / DRWG NO	1293 -SK201H JAN 2020	REVISION NOTE	UPDATED TO AS BUILT CONDITION	F OFFICE	0203 589 0050	DESIGNER	P TOMLINSON
DRWG SCALES	1/100 @ A3	ISSUE DATE	15-02-22	8 OFFICE	ptomlinson@vailwilliams.com		



Vail Williams