


ALL DIMENSIONS TO BE CHECKED AND VERIFIED ON SITE BEFORE COMMENCEMENT OF ANY WORK. ANY DISCREPANCIES TO BE REPORTED.

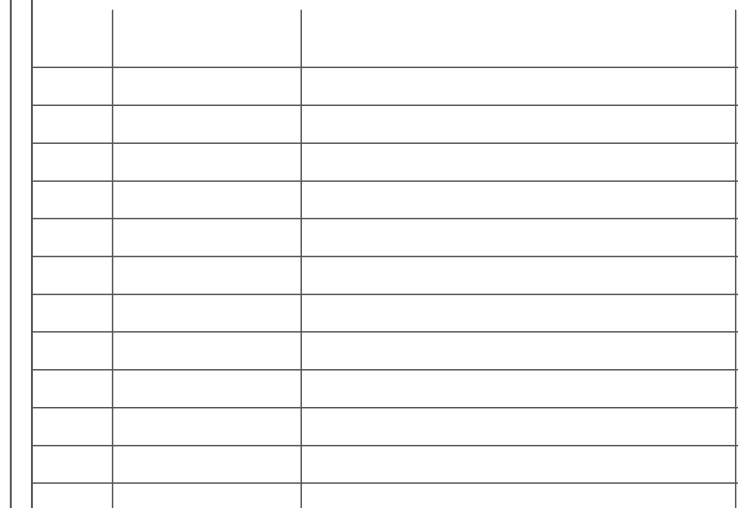

Client	Hyatt Plaza Limited
--------	---------------------

AS BUILT

Drawing No. 6515_GA_GF


Scale 1:50@A1	Revision No.
---------------	--------------

Keepers Cottage, Bearwood Lakes Golf Club
Bearwood Rd, Wokingham, Berkshire, RG41 4S.

Tel: 0345 2186955

www.oaktreeoffice.com

ALL DIMENSIONS TO BE CHECKED AND VERIFIED ON SITE BEFORE COMMENCEMENT OF ANY WORK. ANY DISCREPANCIES TO BE REPORTED.

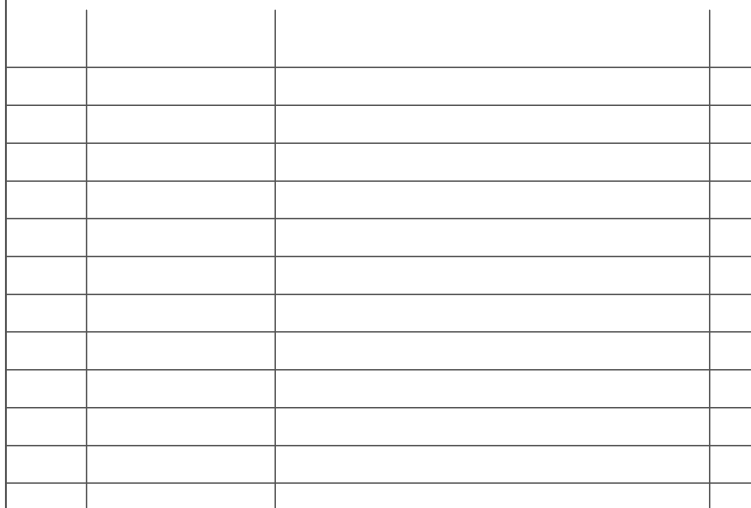

Client	Hyatt Plaza Limited
--------	---------------------

AS BUILT

Drawing Title	GENERAL ARRANGEMENT FF
---------------	---------------------------

Drawn By PM	Date 06.03.25
-------------	---------------

Scale 1:50@A1	Revision No.
---------------	--------------

Keepers Cottage, Bearwood Lakes Golf Club
Bearwood Rd, Wokingham, Berkshire, RG41 4SJ

Tel: 0345 2186955

www.oaktreeoffice.com